

SEPTIC SYSTEM PERMIT

FLATHEAD CITY-COUNTY HEALTH DEPARTMENT

Environmental Health Services
723 5th Ave East, Kalispell, MT 59901

Number	97-289870
Site Eval. Receipt	97-9339
Date Issued	12/18/97
Zone	2
Date Recorded	12.12.97

1. Legal Description: Co. Assess. Tr.# 2AB SEC: 32 TWP: 30 RNG: 21
 Subdiv. Name _____ Lot _____ Blk. _____
 COS # 11836 Parcel Size 5.04 acres
 Property Address 3798 Whitefish Stage, Whitefish

2. Brian and Judy Sommers P.O. Box 2394 Kalispell
 Legal Property Owner Address and Phone

3. Authorization for: New Replacement of Alteration/Repair of Septic System.
 4. Proposed Structure: Conv. Sing. Fam. Mob. Home Multi-fam. (specify) Conv. Sing. Fam.
 Commercial (specify) Conv. Sing. Fam. Other (specify) Conv. Sing. Fam.

5. No. of Bedrooms 3 or No. of Occupants _____ Existing Structures _____

6. Water Supply: Indiv. Multi-user Public (name) Indiv Source Well Proposed

Evaluator's Comments:

7. Soil Type: Gravelly Silt Loam How Determined: Prev. Exp.

8. Depth to Groundwater Table/Bedrock > 7 feet How Determined: Prev. Exp.

System Specifications:

9. Classification 1G Septic Tank Size 900 gallons (min) Absorption Area 600 ft²

10 Drainfield Description

Drainfield is to be located near proposed house site (approximately in the middle of the lot.) Use 300 lineal feet of perforated pipe in two foot wide trenches. Trench depth is to be shallow - no deeper than 30 inches. Perforated pipe and trench bottoms are to be level. Use multiple lines with no single drainfield lateral exceeding 80 feet from point of effluent entry from solid pipe.

Save area for 100% replacement of drainfield.

Plan carefully and be sure of all county regulations prior to installation.

SITE PLAN ??


12/18/97
Date

Joseph W. Russell, R.S.
Signature Authorizing Approval of Permit

* These requirements establish the minimum specifications for this septic system installation. The permit will be voided and declared invalid if the system is not installed within 12 months for class 1, 2, and 4 or 24 months for class 3 and 5 systems. The issuance of this permit authorizes construction of the septic system and requires the installation comply with the FLATHEAD COUNTY REGULATIONS FOR SEWAGE TREATMENT SYSTEMS (FCRSTS). The permit will be void if the system is not utilized as intended within one year of installation. The property owner is responsible for operating and maintaining the system in accordance with FCRSTS. Failure to comply with these regulations may result in revocation of this permit. This permit does not constitute a design and does not bind or obligate this office to guarantee the performance of the system. This permit shall be given to the installer prior to construction. The owner shall give 24hours advance notice for the required inspection of the system. Please call 758-5760.

0982527

LAYOUT

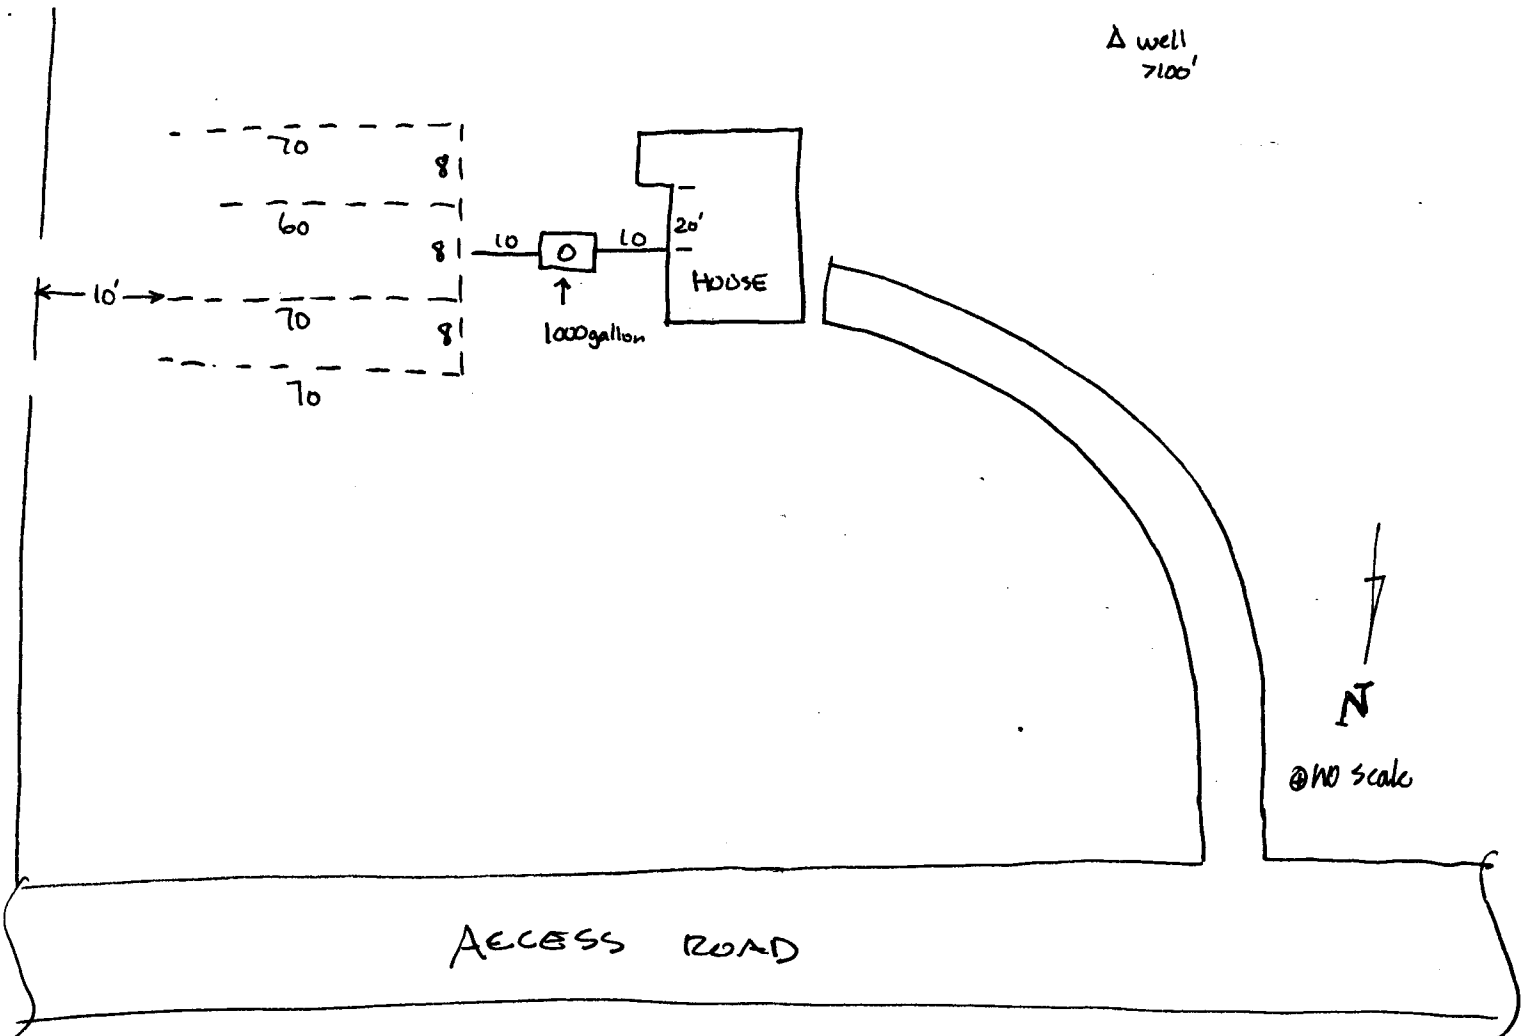

Water source developed at time of inspection? YES NO Distribution YES NO

Disapproved/Date _____ Reason _____

Approved/Date 5/1/98 Comments USE OF 300 LF X 2 FT TRENCH

[Signature]
Inspector's Signature

#53 Cady Construction (Shawn Cady)
Name of Installer