

SEPTIC SYSTEM PERMIT

FLATHEAD CITY-COUNTY HEALTH DEPARTMENT
Environmental Health Services

Number 98-3503N
Site Eval. Receipt Drive By
Date Issued 12/14/98
Zone 6
Date Recorded 11/13/98

1. Legal Description: Co. Assess. Tr.# 4AA SEC: 28 TWP: 29 RNG: 22
Subdiv. Name #15-78-K1436 Tutvedt Lot _____ Blk. _____
COS # _____ Parcel Size 14.9 acres
Property Address 2665 Farm to Market Road, Kalispell

2. Buck Tortensen same
Legal Property Owner _____ Address and Phone _____

3. Authorization for: New Replacement of Alteration/Repair of Septic System.
4. Proposed Structure: Conv. Sing. Fam. Mob. Home Multi-fam. (specify) Conv. Sing. Fam.
Commercial (specify) Conv. Sing. Fam. Other (specify) Conv. Sing. Fam.

5. No. of Bedrooms 4 or No. of Occupants _____ Existing Structures _____

6. Water Supply: Indiv. Multi-user Public (name) Indiv Source well

Evaluator's Comments:

7. Soil Type: see submittal How Determined: see submittal

8. Depth to Groundwater Table/Bedrock see submit How Determined: see submittal

System Specifications:

9. Classification 1G Septic Tank Size 1000 gallons (min) Absorption Area 800 ft2


10 Drainfield Description

Use the approved drainfield site as per subdivision review.
Use 400 lineal feet of perforated pipe in 2 foot wide trenches. Maximum trench depth shall not exceed 36 inches from the natural ground surface. No single drainline may exceed 80 feet from the point of effluent entry. Plan carefully and be sure of all County septic regulations prior to installation.

12/04/98 Jere Johnson, R.S. 
Date Signature Authorizing Approval of Permit

* These requirements establish the minimum specifications for this septic system installation. The permit will be voided and declared invalid if the system is not installed within 12 months for class 1, 2, and 4 or 24 months for class 3 and 5 systems. The issuance of this permit authorizes construction of the septic system and requires the installation comply with the FLATHEAD COUNTY REGULATIONS FOR SEWAGE TREATMENT SYSTEMS (FCRSTS). The permit will be void if the system is not utilized as intended within one year of installation. The property owner is responsible for operating and maintaining the system in accordance with FCRSTS. Failure to comply with these regulations may result in revocation of this permit. This permit does not constitute a design and does not bind or obligate this office to guarantee the performance of the system. This permit shall be given to the installer prior to construction. The owner shall give 24hours advance notice for the required inspection of the system. Please call 758-5760.

LAYOUT

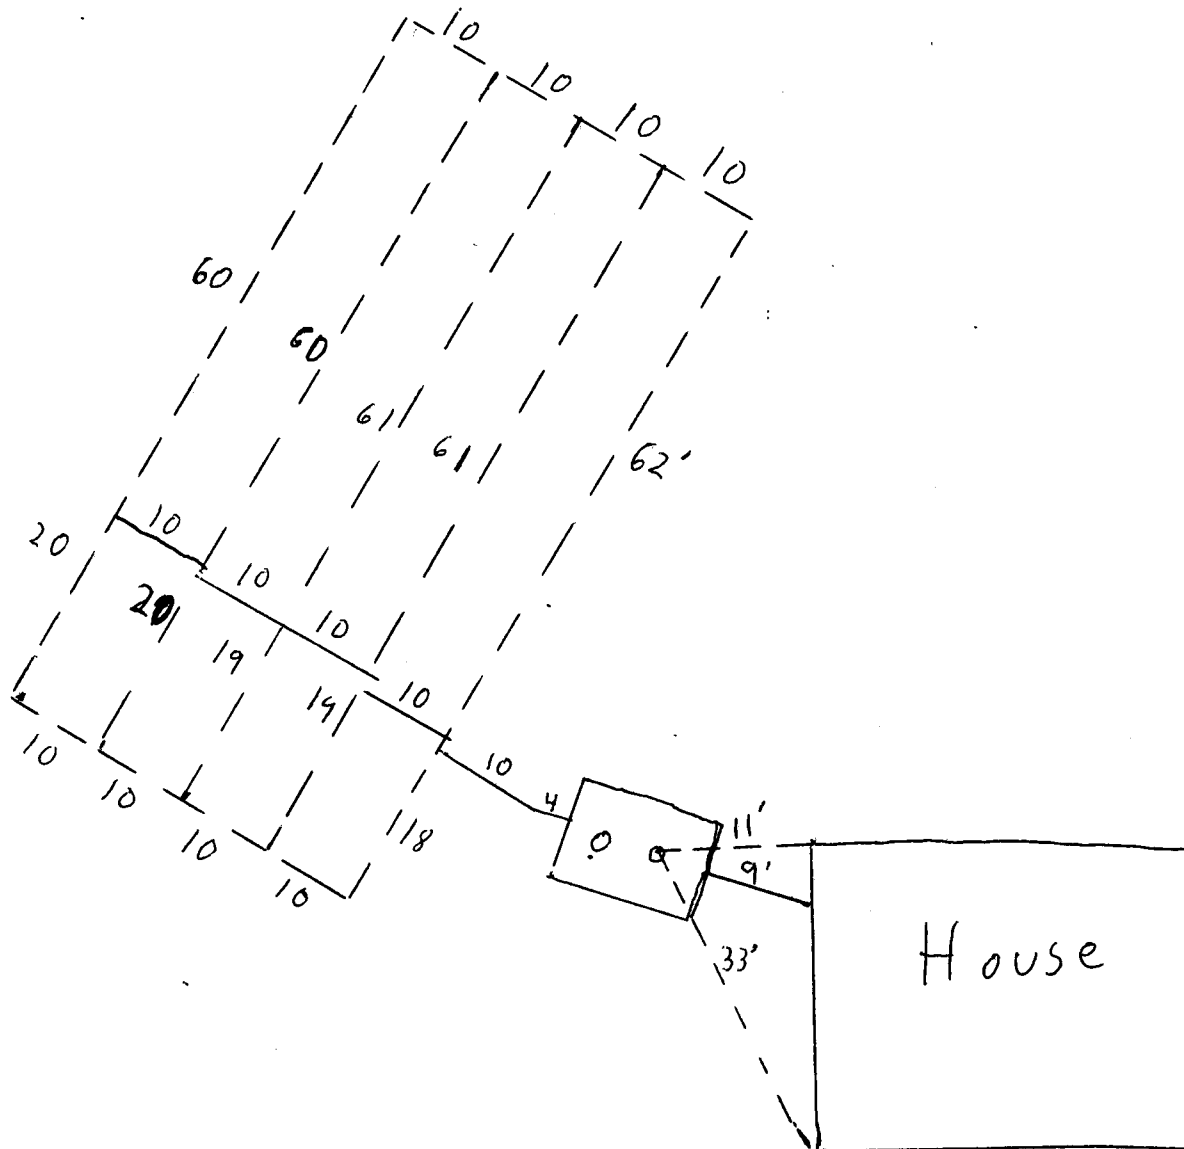

Water source developed at time of inspection? YES NO Distribution YES NO

Disapproved/Date _____ Reason _____

Approved/Date 22 MAR 99 Comments Well is over 100' away SDR35 solid Pipe

400' of drain field

Inspector's Signature D. S. Glen Olson Name of Installer BLST